


F-715 A & B
PARTICULATE FILTER
SEPARATOR

SIZE: 18" O.D. x 42.5" T/T
OPERATING: 230 PSIG
DESIGN: 275 PSIG @ 100°F
MDMT: -20°F @ 275 PSIG
DESIGN CAP: 180 GPM @ 2.25 PSID CLEAN

47
46
45
47
46
45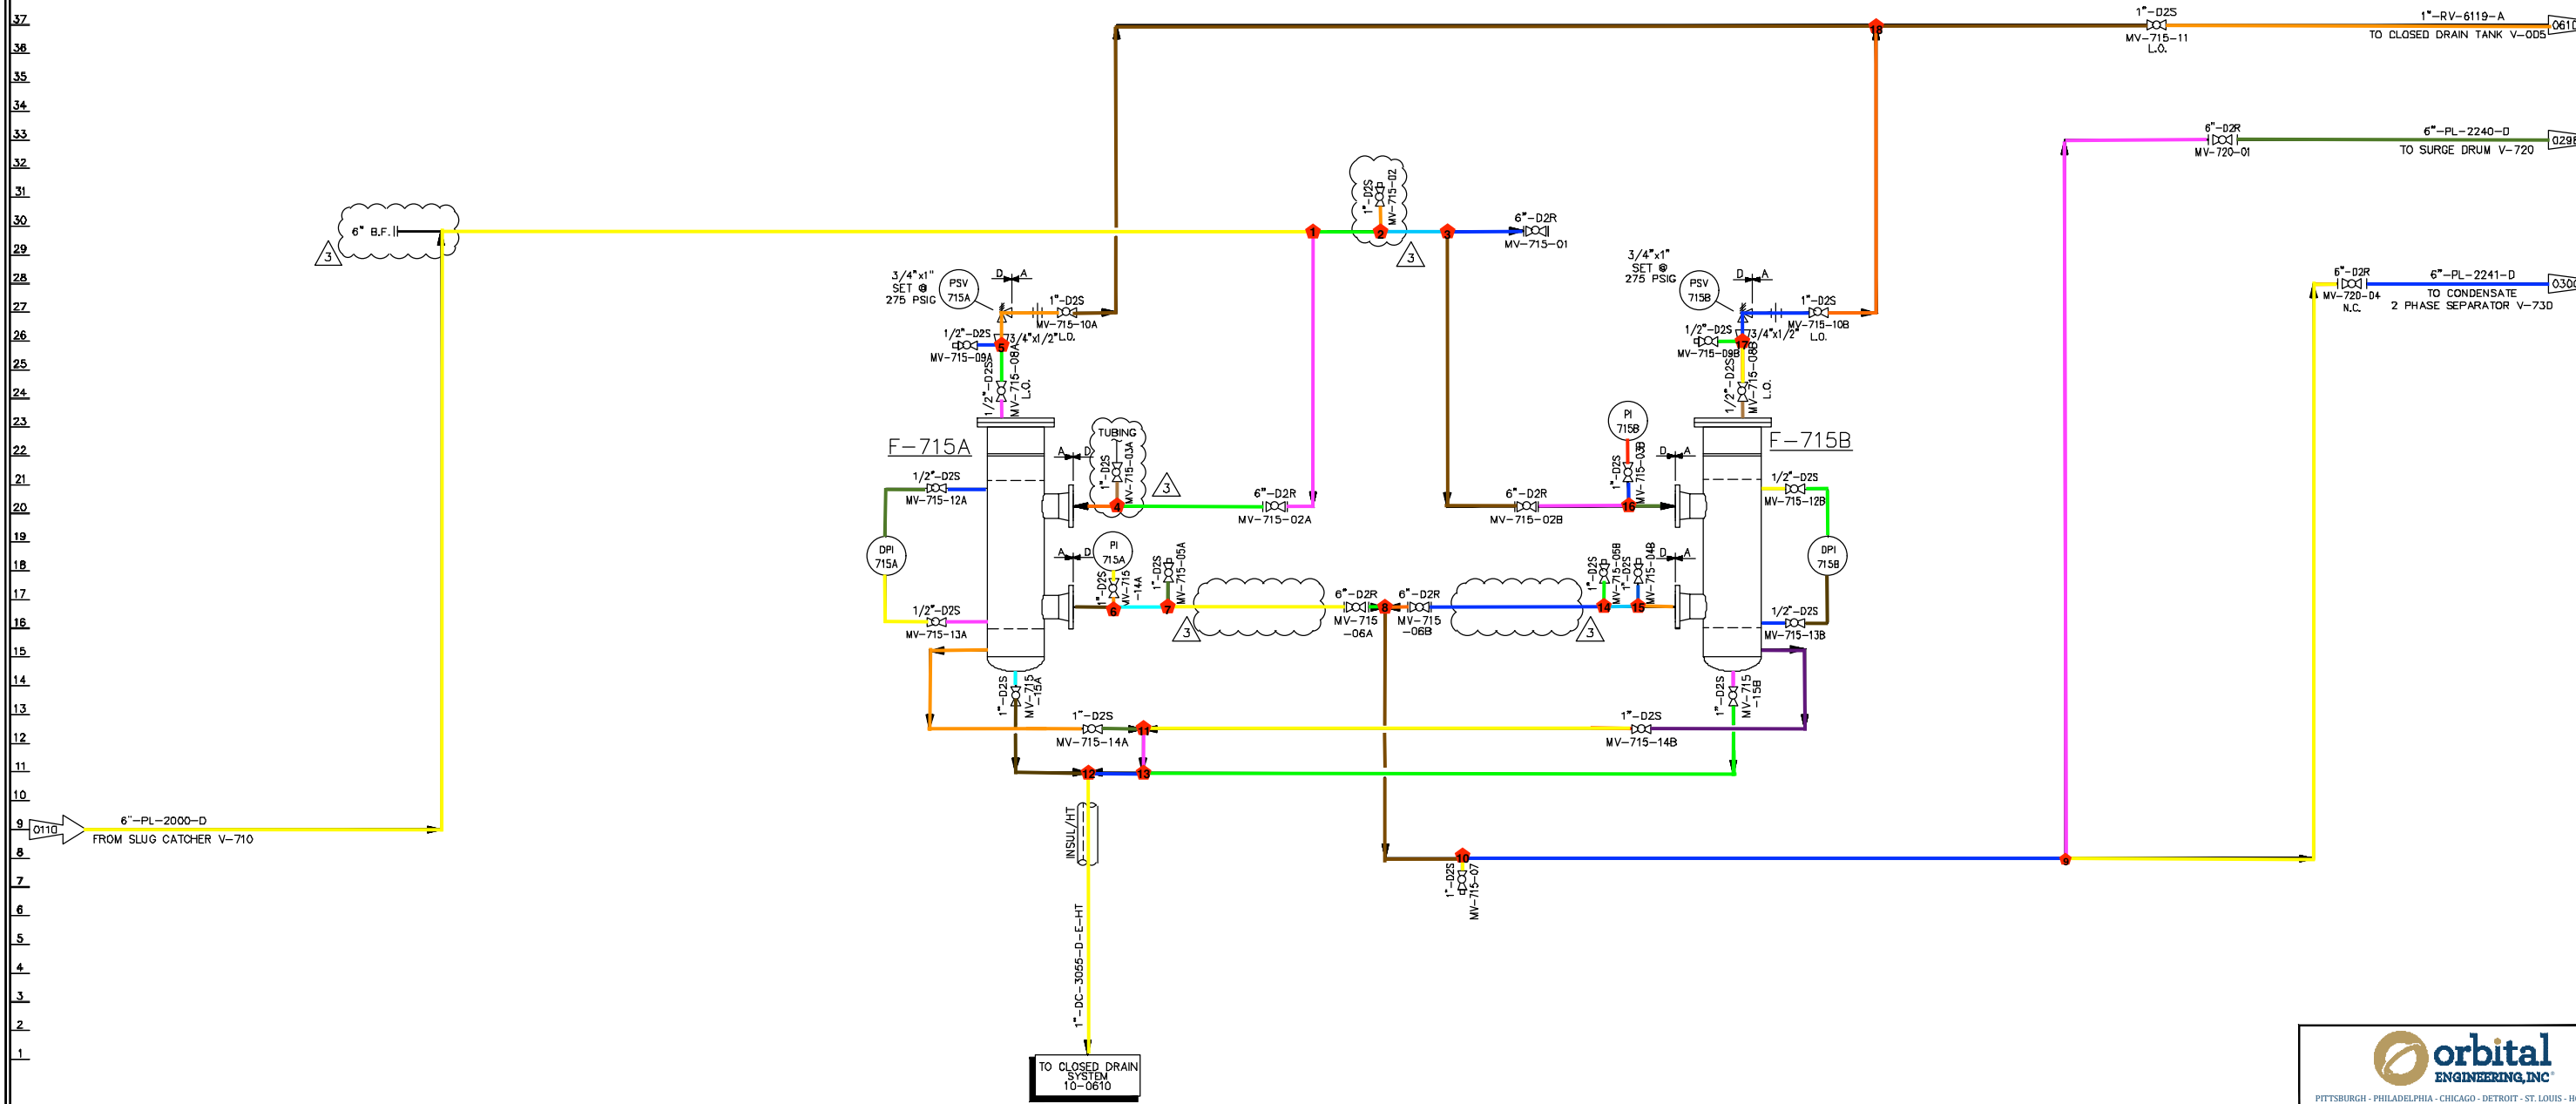
PROJECT PIT.22.7136



MARCELLUS SHALE DEVELOPMENT
MAJORSVILLE CGP
PIPING & INSTRUMENTATION DIAGRAM
PARTICULATE FILTER SEPARATORS

REV.	DESCRIPTION	BY	CHK'D	APP'D	DATE	DRAWN	PH	03/11/14
3	AS-BUILT FOR PHA	RCA	KBK	JMM	04/01/22			
2	MOC# 05242016	BMS	CB	BMS	09/06/16	CLIENT	-	-
1	AS-BUILT	CNH	KRE	BMS	08/24/15	APPROVED	JD	03/11/14
0	ISSUED FOR CONSTRUCTION	PH	JC	JD	03/11/14	CHECKED	JC	03/11/14

JOB NO. 009963.001 DWG. NO. MJV-CGP-10-0297