


F-715 A & B  
PARTICULATE FILTER  
SEPARATOR

SIZE: 18" O.D. x 42.5" T/T  
OPERATING: 230 PSIG  
DESIGN: 275 PSIG @ 100°F  
MDMT: -20°F @ 275 PSIG  
DESIGN CAP: 180 GPM @ 2.25 PSID CLEAN

47  
46  
45  
47  
46  
45  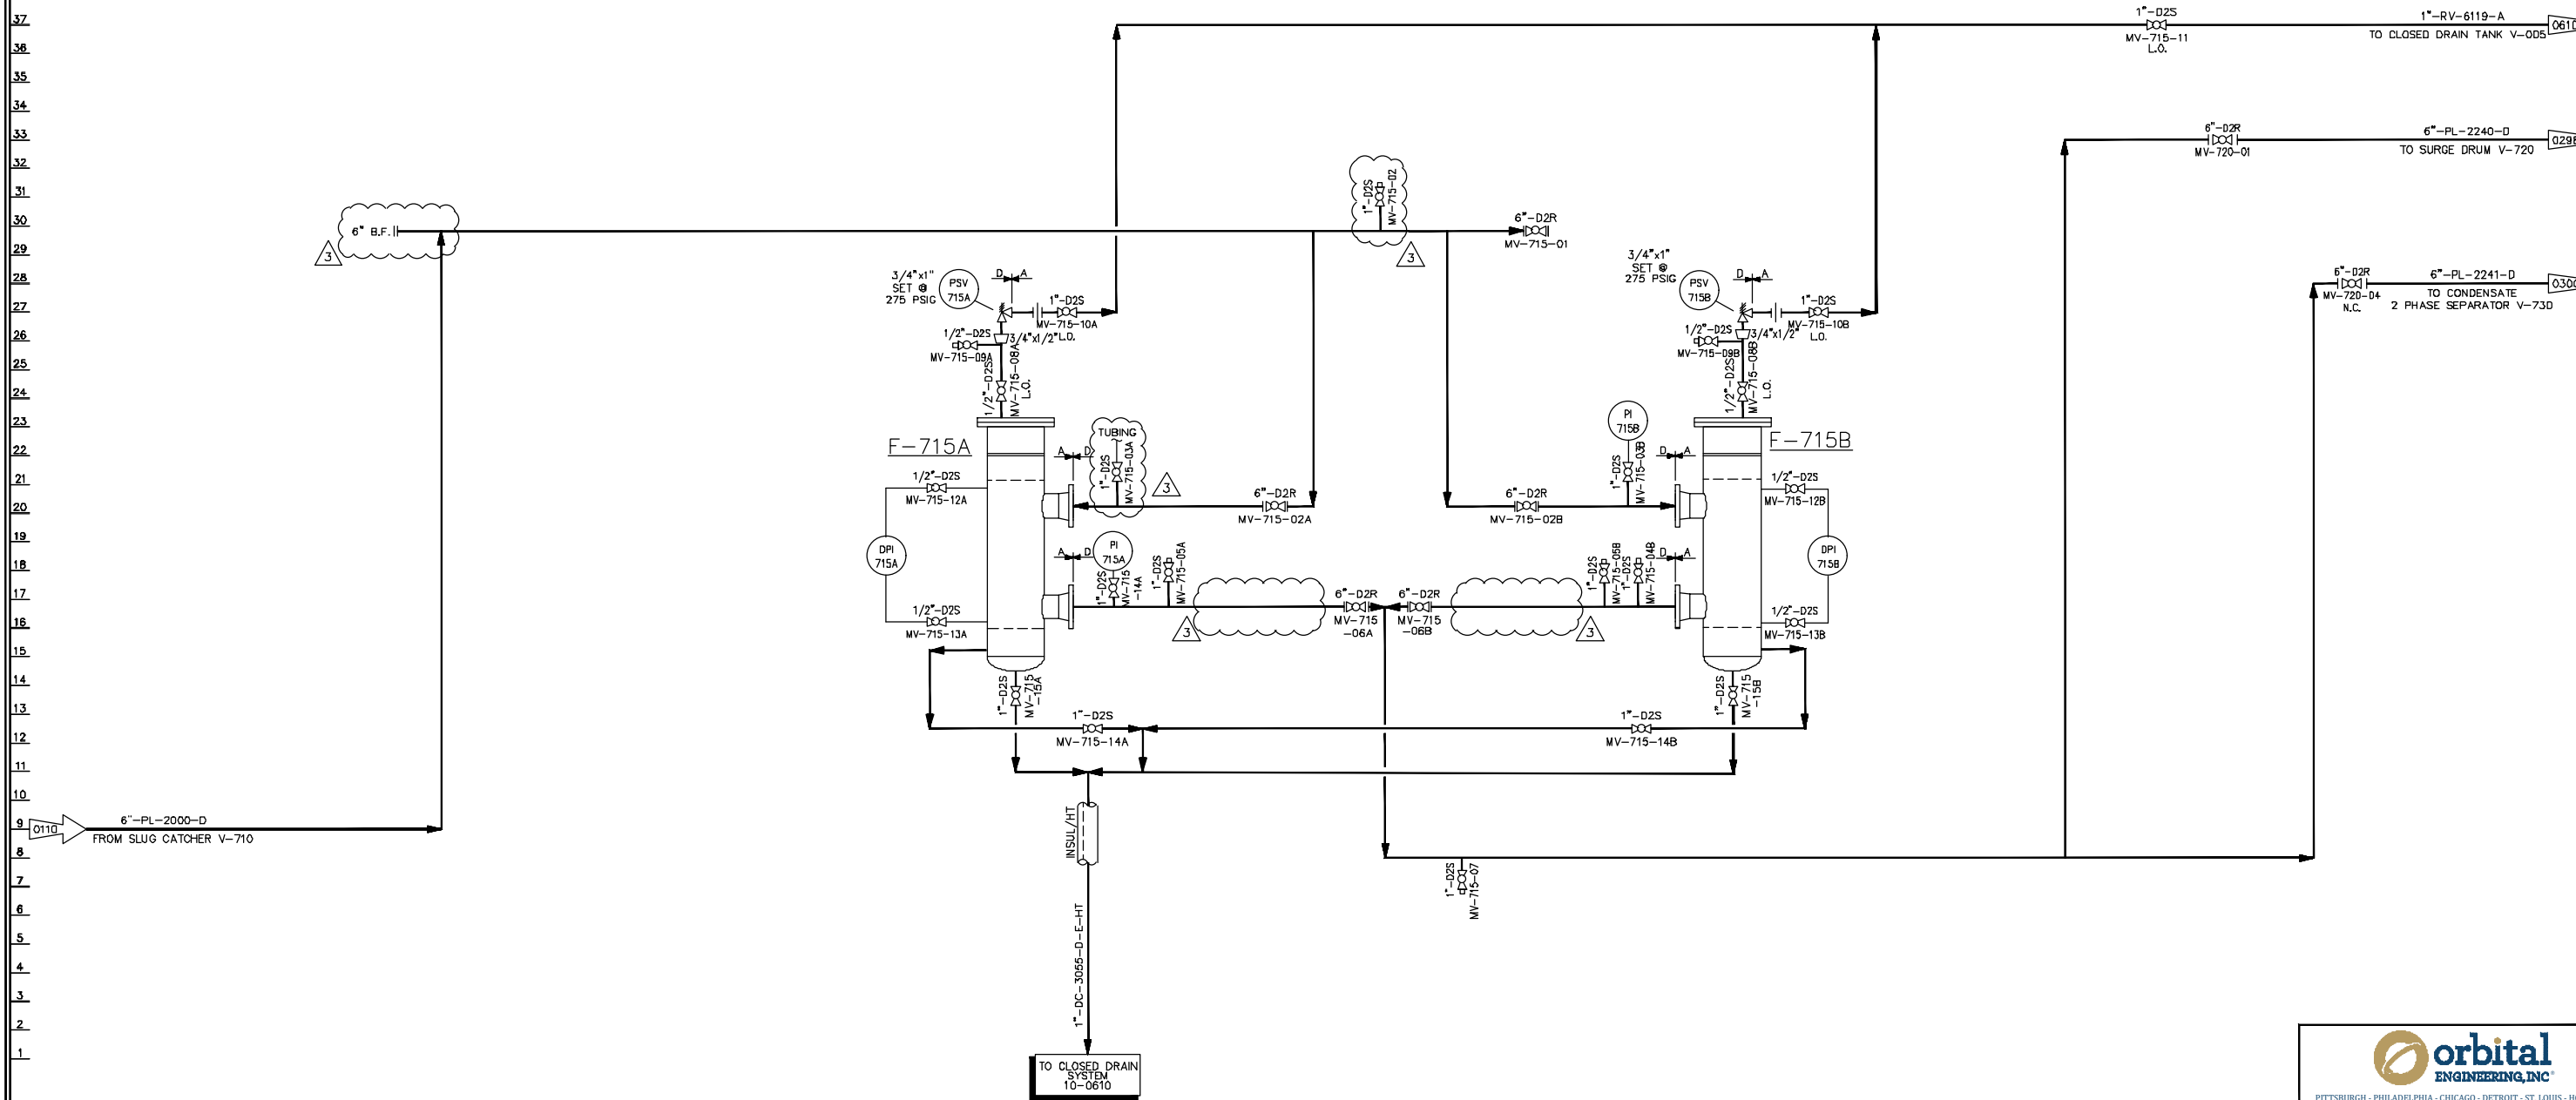
PROJECT PIT.22.7136





MARCELLUS SHALE DEVELOPMENT  
MAJORSVILLE CGP  
PIPING & INSTRUMENTATION DIAGRAM  
PARTICULATE FILTER SEPARATORS

| REV. | DESCRIPTION             | BY  | CHK'D | APP'D | DATE     | DRAWN    | PH | 03/11/14 |
|------|-------------------------|-----|-------|-------|----------|----------|----|----------|
| 3    | AS-BUILT FOR PHA        | RCA | KBK   | JMM   | 04/01/22 |          |    |          |
| 2    | MOC# 05242016           | BMS | CB    | BMS   | 09/06/16 | CLIENT   | -  | -        |
| 1    | AS-BUILT                | CNH | KRE   | BMS   | 08/24/15 | APPROVED | JD | 03/11/14 |
| 0    | ISSUED FOR CONSTRUCTION | PH  | JC    | JD    | 03/11/14 | CHECKED  | JC | 03/11/14 |

JOB NO. 009963.001 DWG. NO. MJV-CGP-10-0297

P-745  
SUBMERSIBLE SUMP PUMP

V-745  
NGL STABILIZER  
30" OD X 55'-0" S/S TWO (2) 20' SECTIONS  
M.W.P.: 300 PSIG @ 375 F  
2" H

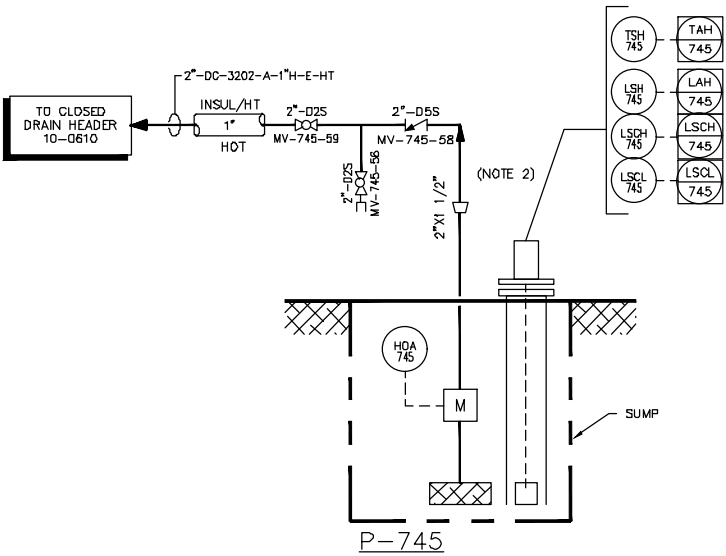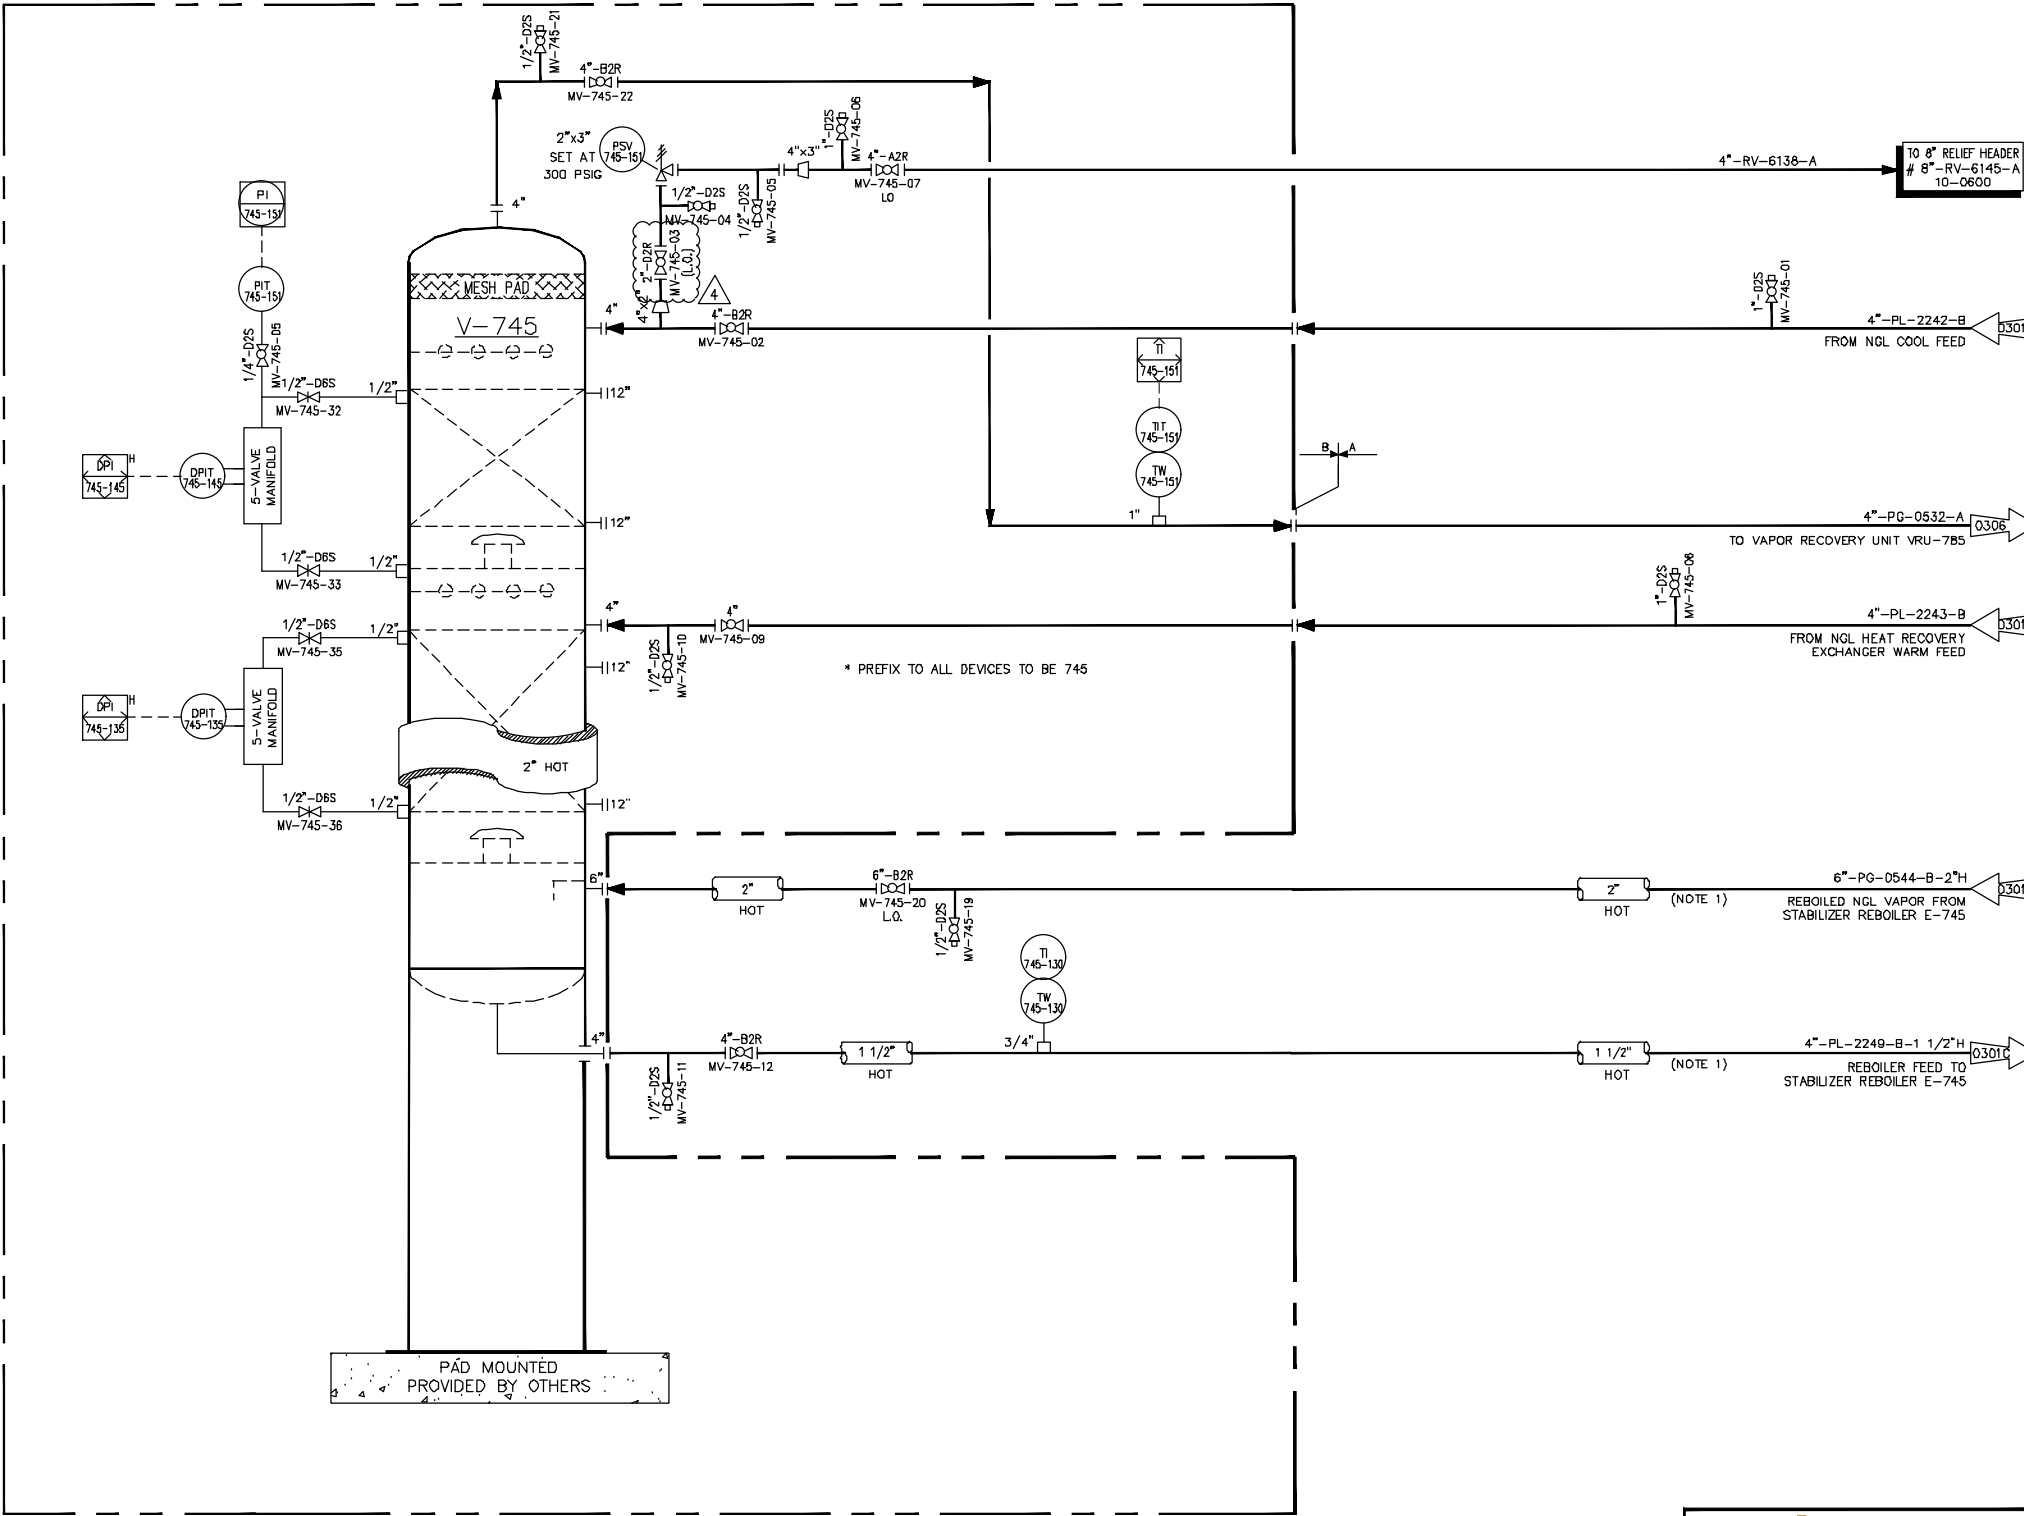

- NOTES:
1. VENDOR SUPPLIED PIPING.
  2. HIGH LEVEL WILL TURN ON SUMP PUMP. LOW LEVEL WILL TURN OFF SUMP PUMP.

| REV. | DESCRIPTION                             | BY  | CHK'D | APP'D | DATE     | DRAWN | PH | 03/11/14 |
|------|-----------------------------------------|-----|-------|-------|----------|-------|----|----------|
| 5    | REVISED PER PHA REDLINES                | RCA | KBK   | JMM   | 09/02/22 |       |    |          |
| 4    | AS-BUILT FOR PHA                        | RCA | KBK   | JMM   | 04/01/22 |       |    |          |
| 3    | REVISED FOR MOC # 08282015              | BMS | CB    | BMS   | 09/18/15 |       |    |          |
| 2    | AS-BUILT                                | CNH | KRE   | BMS   | 08/24/15 |       |    |          |
| 1    | IFC - REVISED PER HAZOP RECOMMENDATIONS | SS  | EH    | JC    | 04/18/14 |       |    |          |
| 0    | ISSUED FOR CONSTRUCTION                 | PH  | JC    | JD    | 03/11/14 |       |    |          |

PITTSBURGH - PHILADELPHIA - CHICAGO - DETROIT - ST. LOUIS - HOUSTON

PROJECT **PIT.22.7136**

Marcellus Shale Development  
MAJORSVILLE CGP  
PIPING & INSTRUMENTATION DIAGRAM  
NGL STABILIZER TOWER

|                  |            |          |
|------------------|------------|----------|
| CLIENT           | -          | -        |
| APPROVED         | JD         | 03/11/14 |
| CHECKED          | JC         | 03/11/14 |
| JOB NO.          | 009963.001 | DWG. NO. |
| MJV-CGP-10-0301B |            |          |

E-742  
NGL HEAT RECOVERY EXCHANGER  
4" X 3/4" X 240" 44MMBTU/HR  
MWP 300 PSIG @ 375° F. (SHELL)  
300 PSIG @ 250° F. (TUBE)  
1/16" C.A. (EXCL. TUBES)

